


Move window
to Achieve 24
on 5/06 (D)(3)

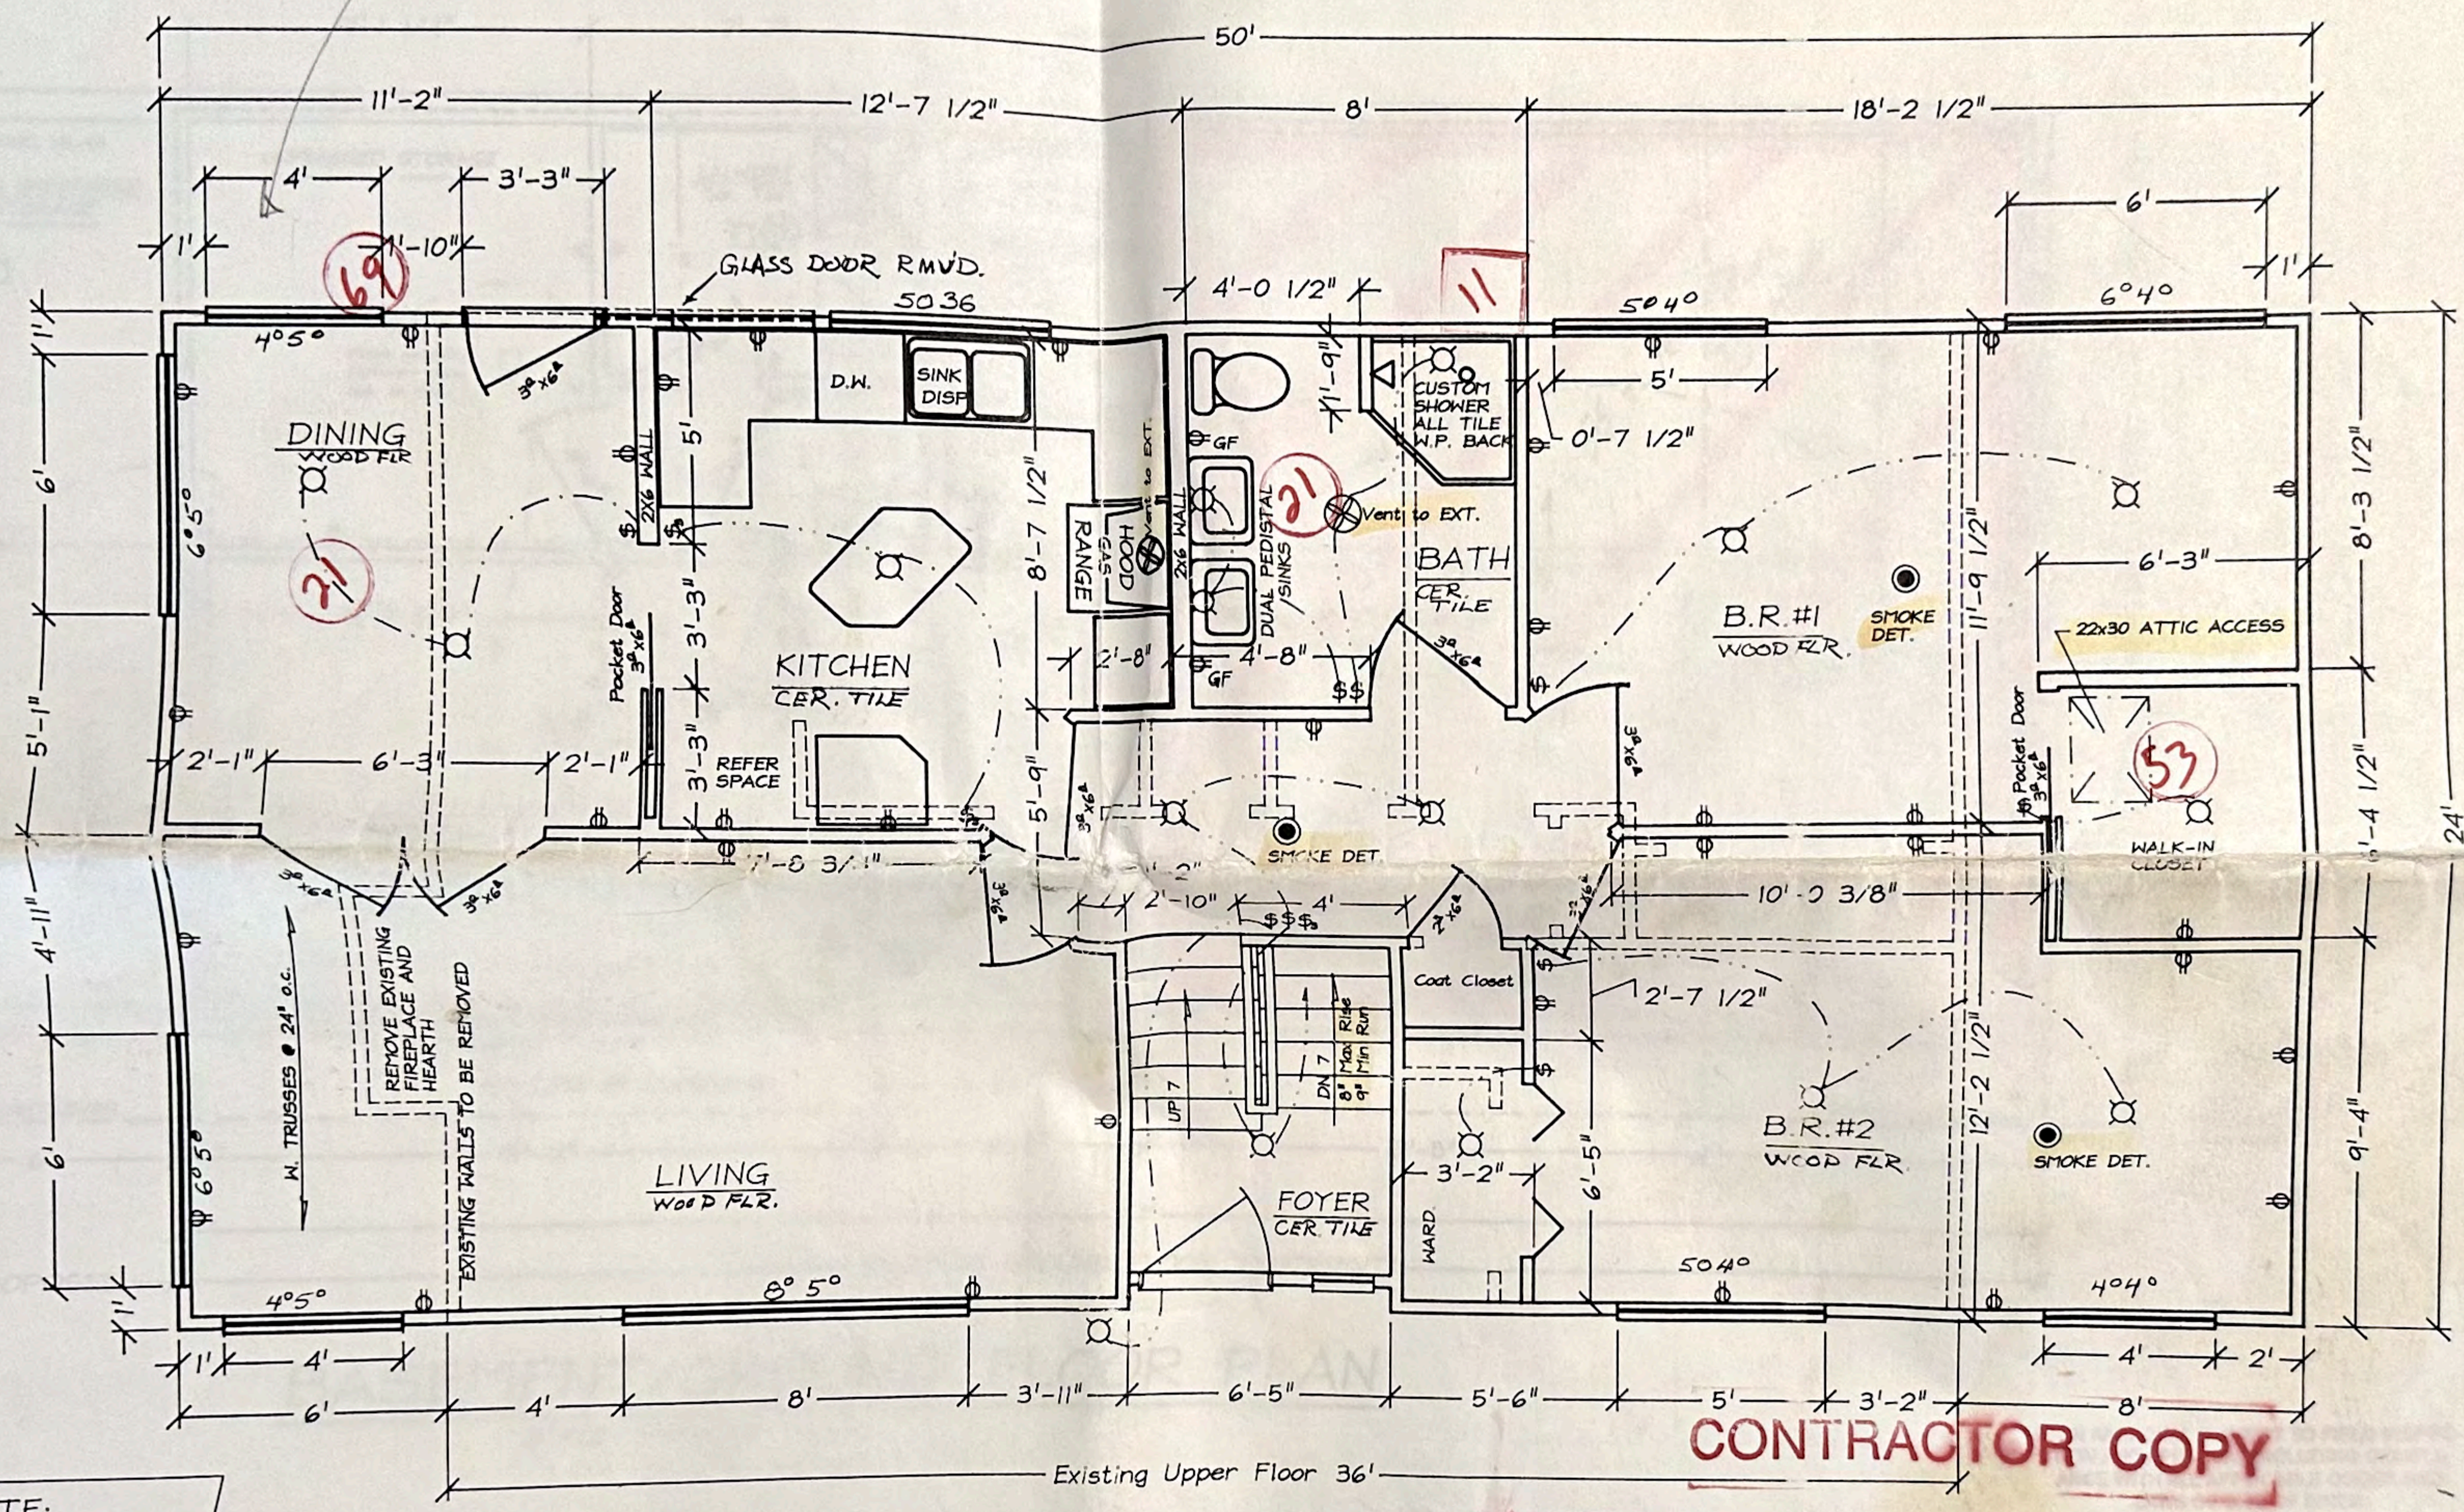

ELECTRICAL, PLUMBING AND MECHANICAL PERMITS MAY BE REQUIRED

#12 Wire Minimum.
GFCI Recept. Front & Back

24 HOUR NOTICE
REQUIRED PRIOR TO NEED FOR INSPECTION

775-5440

CONTRACTOR COPY

Air Chambers Required At All Sinks & Washer

NOTE:
--- INDICATES WALL TO BE REMOVED

MAIN FLOOR PLAN! (with new electrical)

SCALE: 1/4" = 1'-0"

21

**CITY OF BRIER
APPROVED PLAN**

DATE: 7-21-94

BY: *Kathy West*

**SHALL REMAIN ON
JOB SITE**

PLAN APPROVAL SUBJECT TO FIELD INSPECTION AND APPROVAL INCLUDING COMPLIANCE WITH ALL APPLICABLE CODES AND ORDINANCES OF CITY OF BRIER.

Tosti-Lane Home Remodel Project

3794 232nd Pl. S.W. Brier, WA 98036 771-8923
Drawn: 7/8/94 By: Dave Tosti-Lane Rev: 7/14/94

Air Chambers Required At All Sinks & Washer
IT SHALL NOT BE CONSTRUED THAT THE PLAN REVIEW WARRANTS OR GUARANTEES THE COMPLETENESS OR CORRECTNESS OF THE PLAN OR DRAWINGS SUBMITTED AS PERTAINS TO APPLICABLE CODES OR LAWS. ALL REVIEWS ARE SUBJECT TO FIELD INSPECTION AND APPROVAL. ALL CHANGES OR AMENDMENTS SHALL BE SUBMITTED FOR APPROVAL PRIOR TO EXECUTION.

WSEC #
BLDG., PLBG. MECH., ELECT. #

1 of 6

Plan Review #B94042